


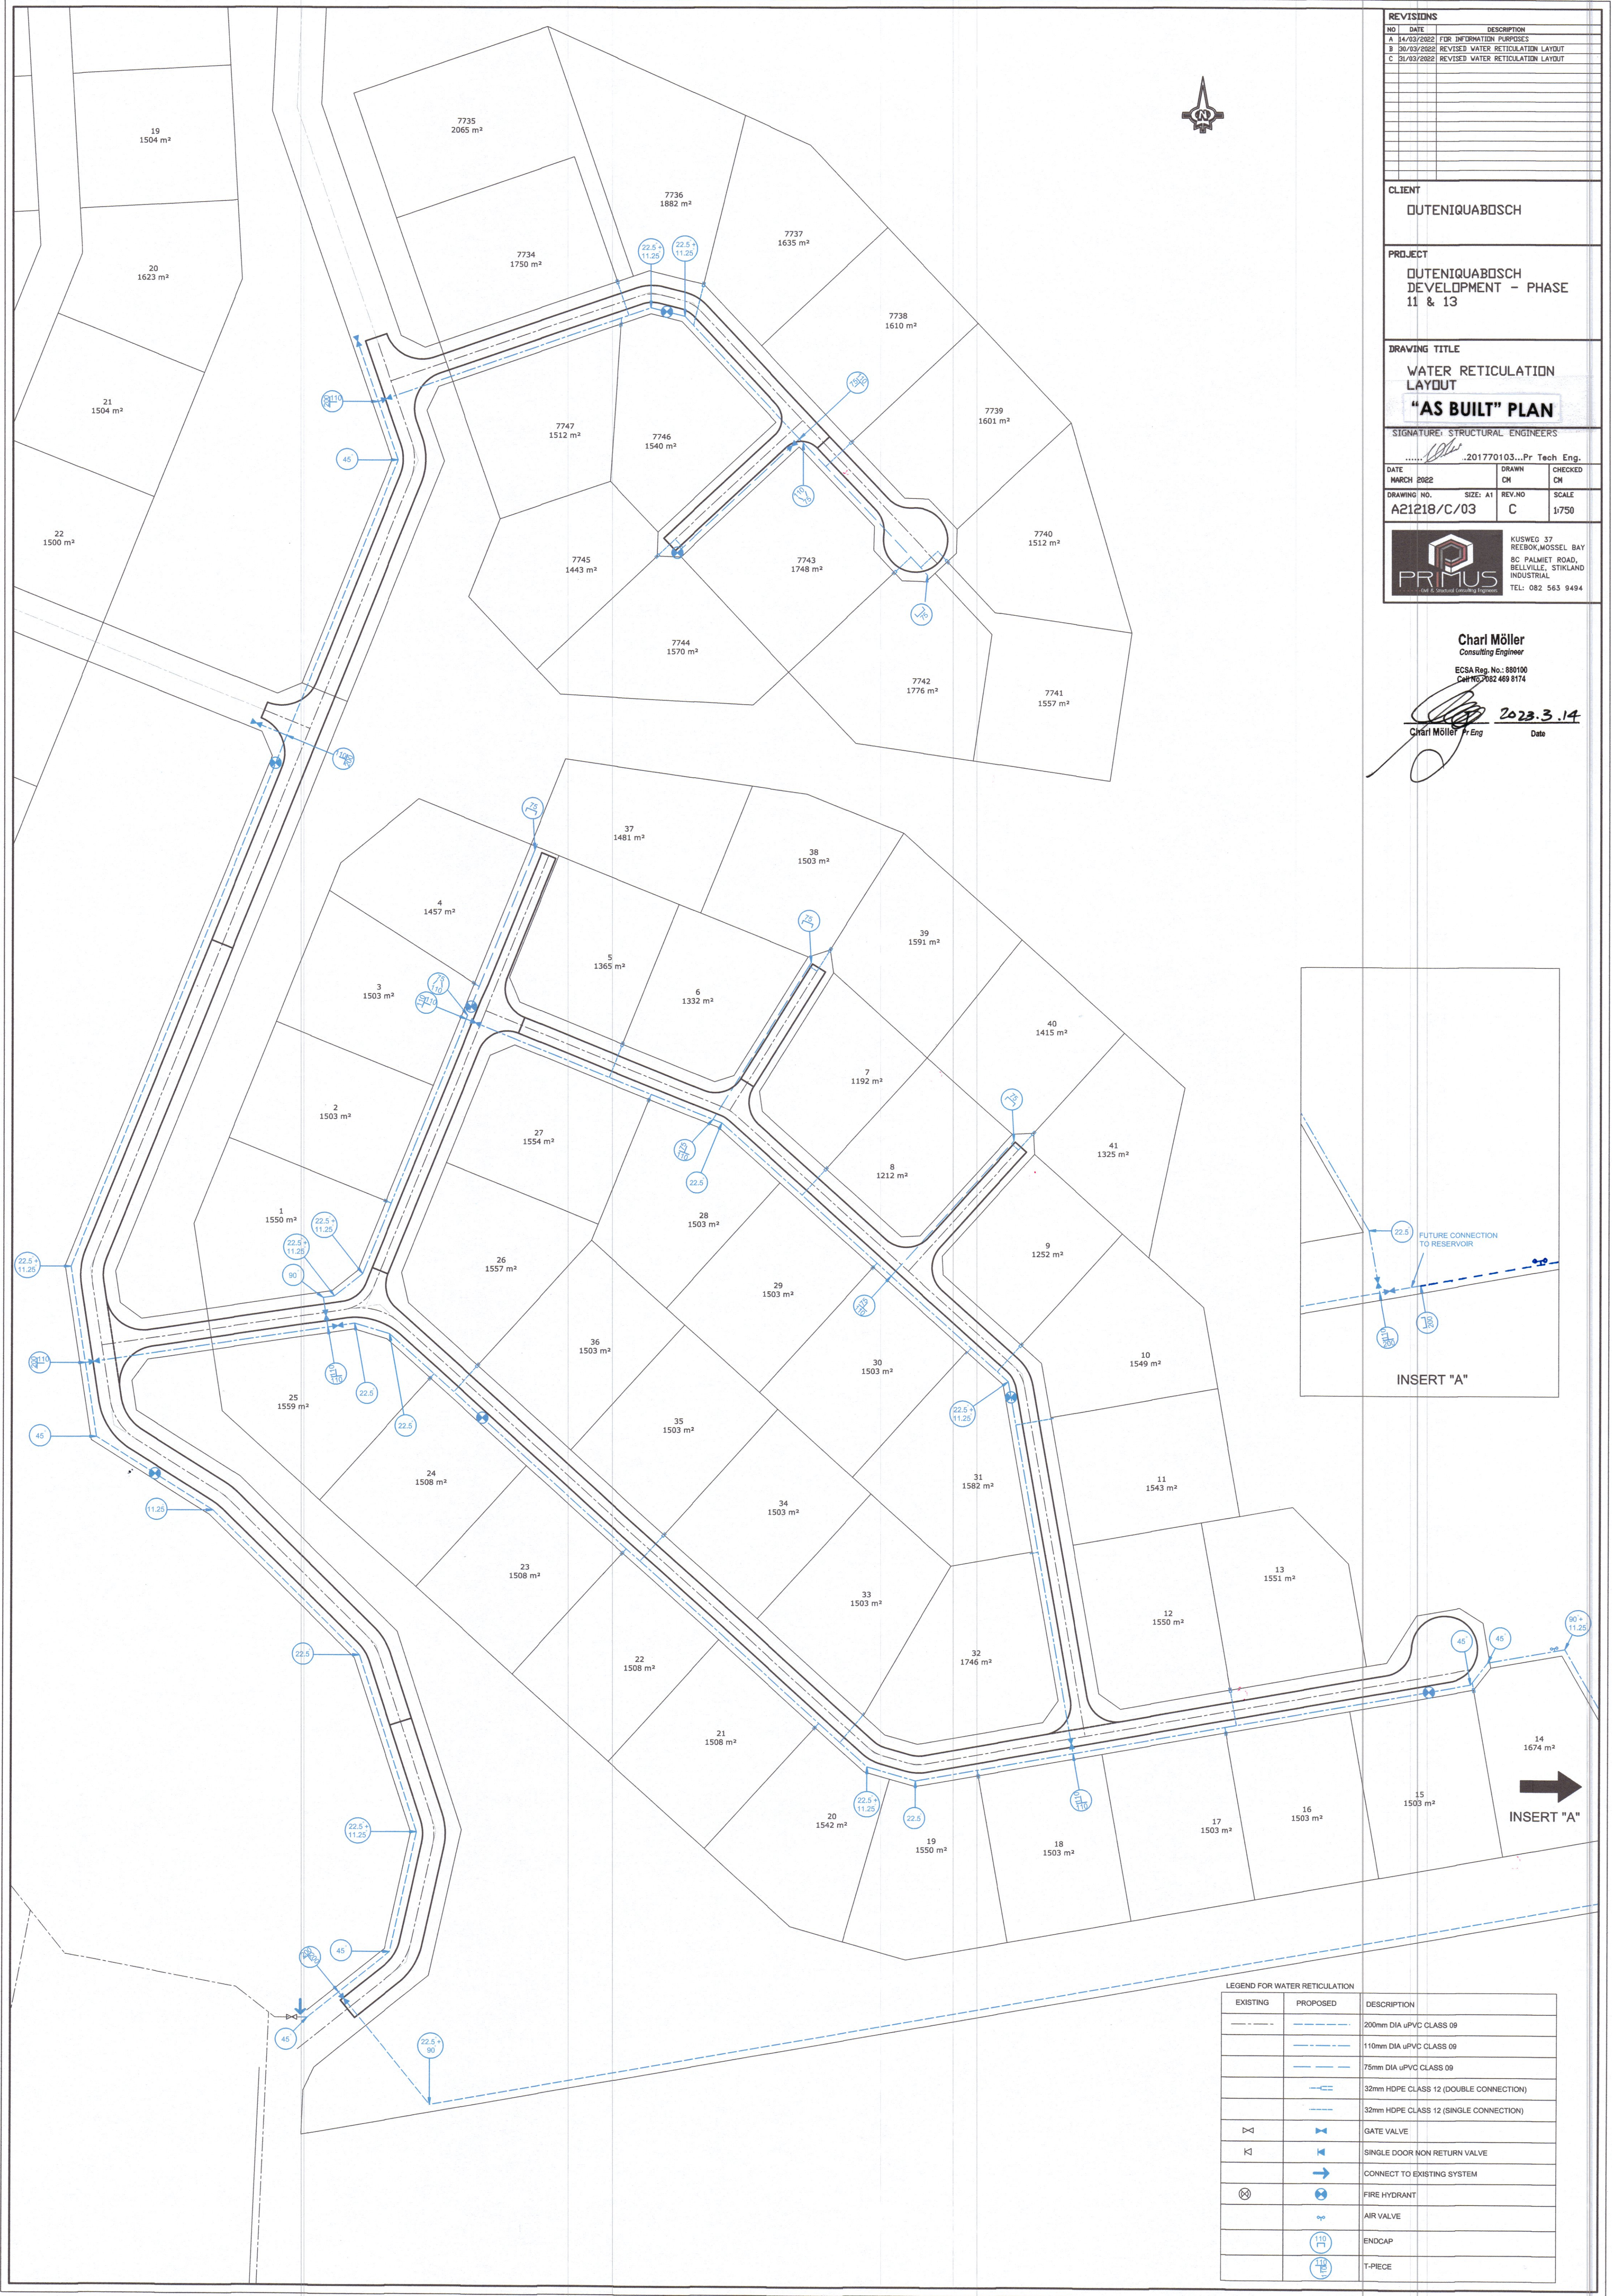

REVISIONS

NO	DATE	DESCRIPTION
A	14/03/2022	FOR INFORMATION PURPOSES
B	30/03/2022	REVISED WATER RETICULATION LAYOUT
C	31/03/2022	REVISED WATER RETICULATION LAYOUT

CLIENT

OUTENIQUABOSCH

PROJECT

OUTENIQUABOSCH
DEVELOPMENT - PHASE
11 & 13

DRAWING TITLE

WATER RETICULATION
LAYOUT
"AS BUILT" PLAN

SIGNATURE: STRUCTURAL ENGINEERS

....., 201770103...Pr Tech Eng.

DATE

MARCH 2022

DRAWN

CM

CHECKED

CM

DRAWING NO.

A21218/C/03

SIZE: A1

REV.NO

C

SCALE

1:750




PRIMUS
Civil & Structural Consulting Engineers

KUSWEG 37
REEBOK, MOSSEL BAY
8C PALMIET ROAD,
BELLVILLE, STIKLAND
INDUSTRIAL
TEL: 082 563 9494

Charl Möller
Consulting Engineer

ECSA Reg. No.: 880100
Cert No: 062 469 0174

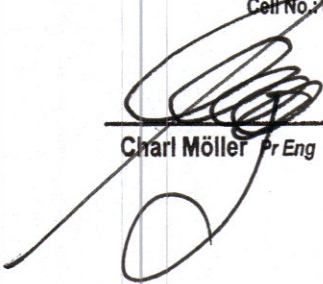

2023.3.14

Charl Möller Pr Eng

Date

LEGEND FOR WATER RETICULATION		
EXISTING	PROPOSED	DESCRIPTION
		200mm DIA uPVC CLASS 09
		110mm DIA uPVC CLASS 09
		75mm DIA uPVC CLASS 09
		32mm HDPE CLASS 12 (DOUBLE CONNECTION)
		32mm HDPE CLASS 12 (SINGLE CONNECTION)
		GATE VALVE
		SINGLE DOOR NON RETURN VALVE
		CONNECT TO EXISTING SYSTEM
		FIRE HYDRANT
		AIR VALVE
		ENDCAP
		T-PIECE