


Er	SG No.	Y	X
8463	83697.237		3775082.061
8464	83666.009		3775070.765
8465	83635.069		3775060.156
8466	83601.926		3775053.922
8467	83536.763		3775077.409
8468	83510.996		3775094.171
8469	83485.966		3775111.767
8470	83483.888		3775113.003
8471	83463.027		3775149.336
8472	83438.810		3775208.491
8473	83426.996		3775234.367
8474	83418.930		3775265.851
8475	83408.206		3775316.858
8476	83407.683		3775351.238
8477	83408.006		3775378.407
8478	83418.922		3775390.907
8479	83447.565		3775422.151
8480	83519.605		3775420.585
8481	83554.208		3775420.044
8482	83556.453		3775379.445
8483	83511.747		3775373.655
8484	83511.773		3775346.335
8485	83511.144		3775317.104
8486	83531.532		3775247.135
8487	83577.755		3775196.136
8488	83602.782		3775177.462
8489	83628.819		3775161.948
8490	83636.131		3775143.336
8491	83646.698		3775114.533
8492	83618.955		3775104.968
8493	83552.602		3775122.911
8494	83529.397		3775137.919
8495	83512.995		3775150.794
8496	83504.604		3775170.564
8497	83480.749		3775226.014
8498	83469.284		3775254.438
8499	83457.431		3775308.566
8500	83453.161		3775340.197
8501	83454.103		3775359.706

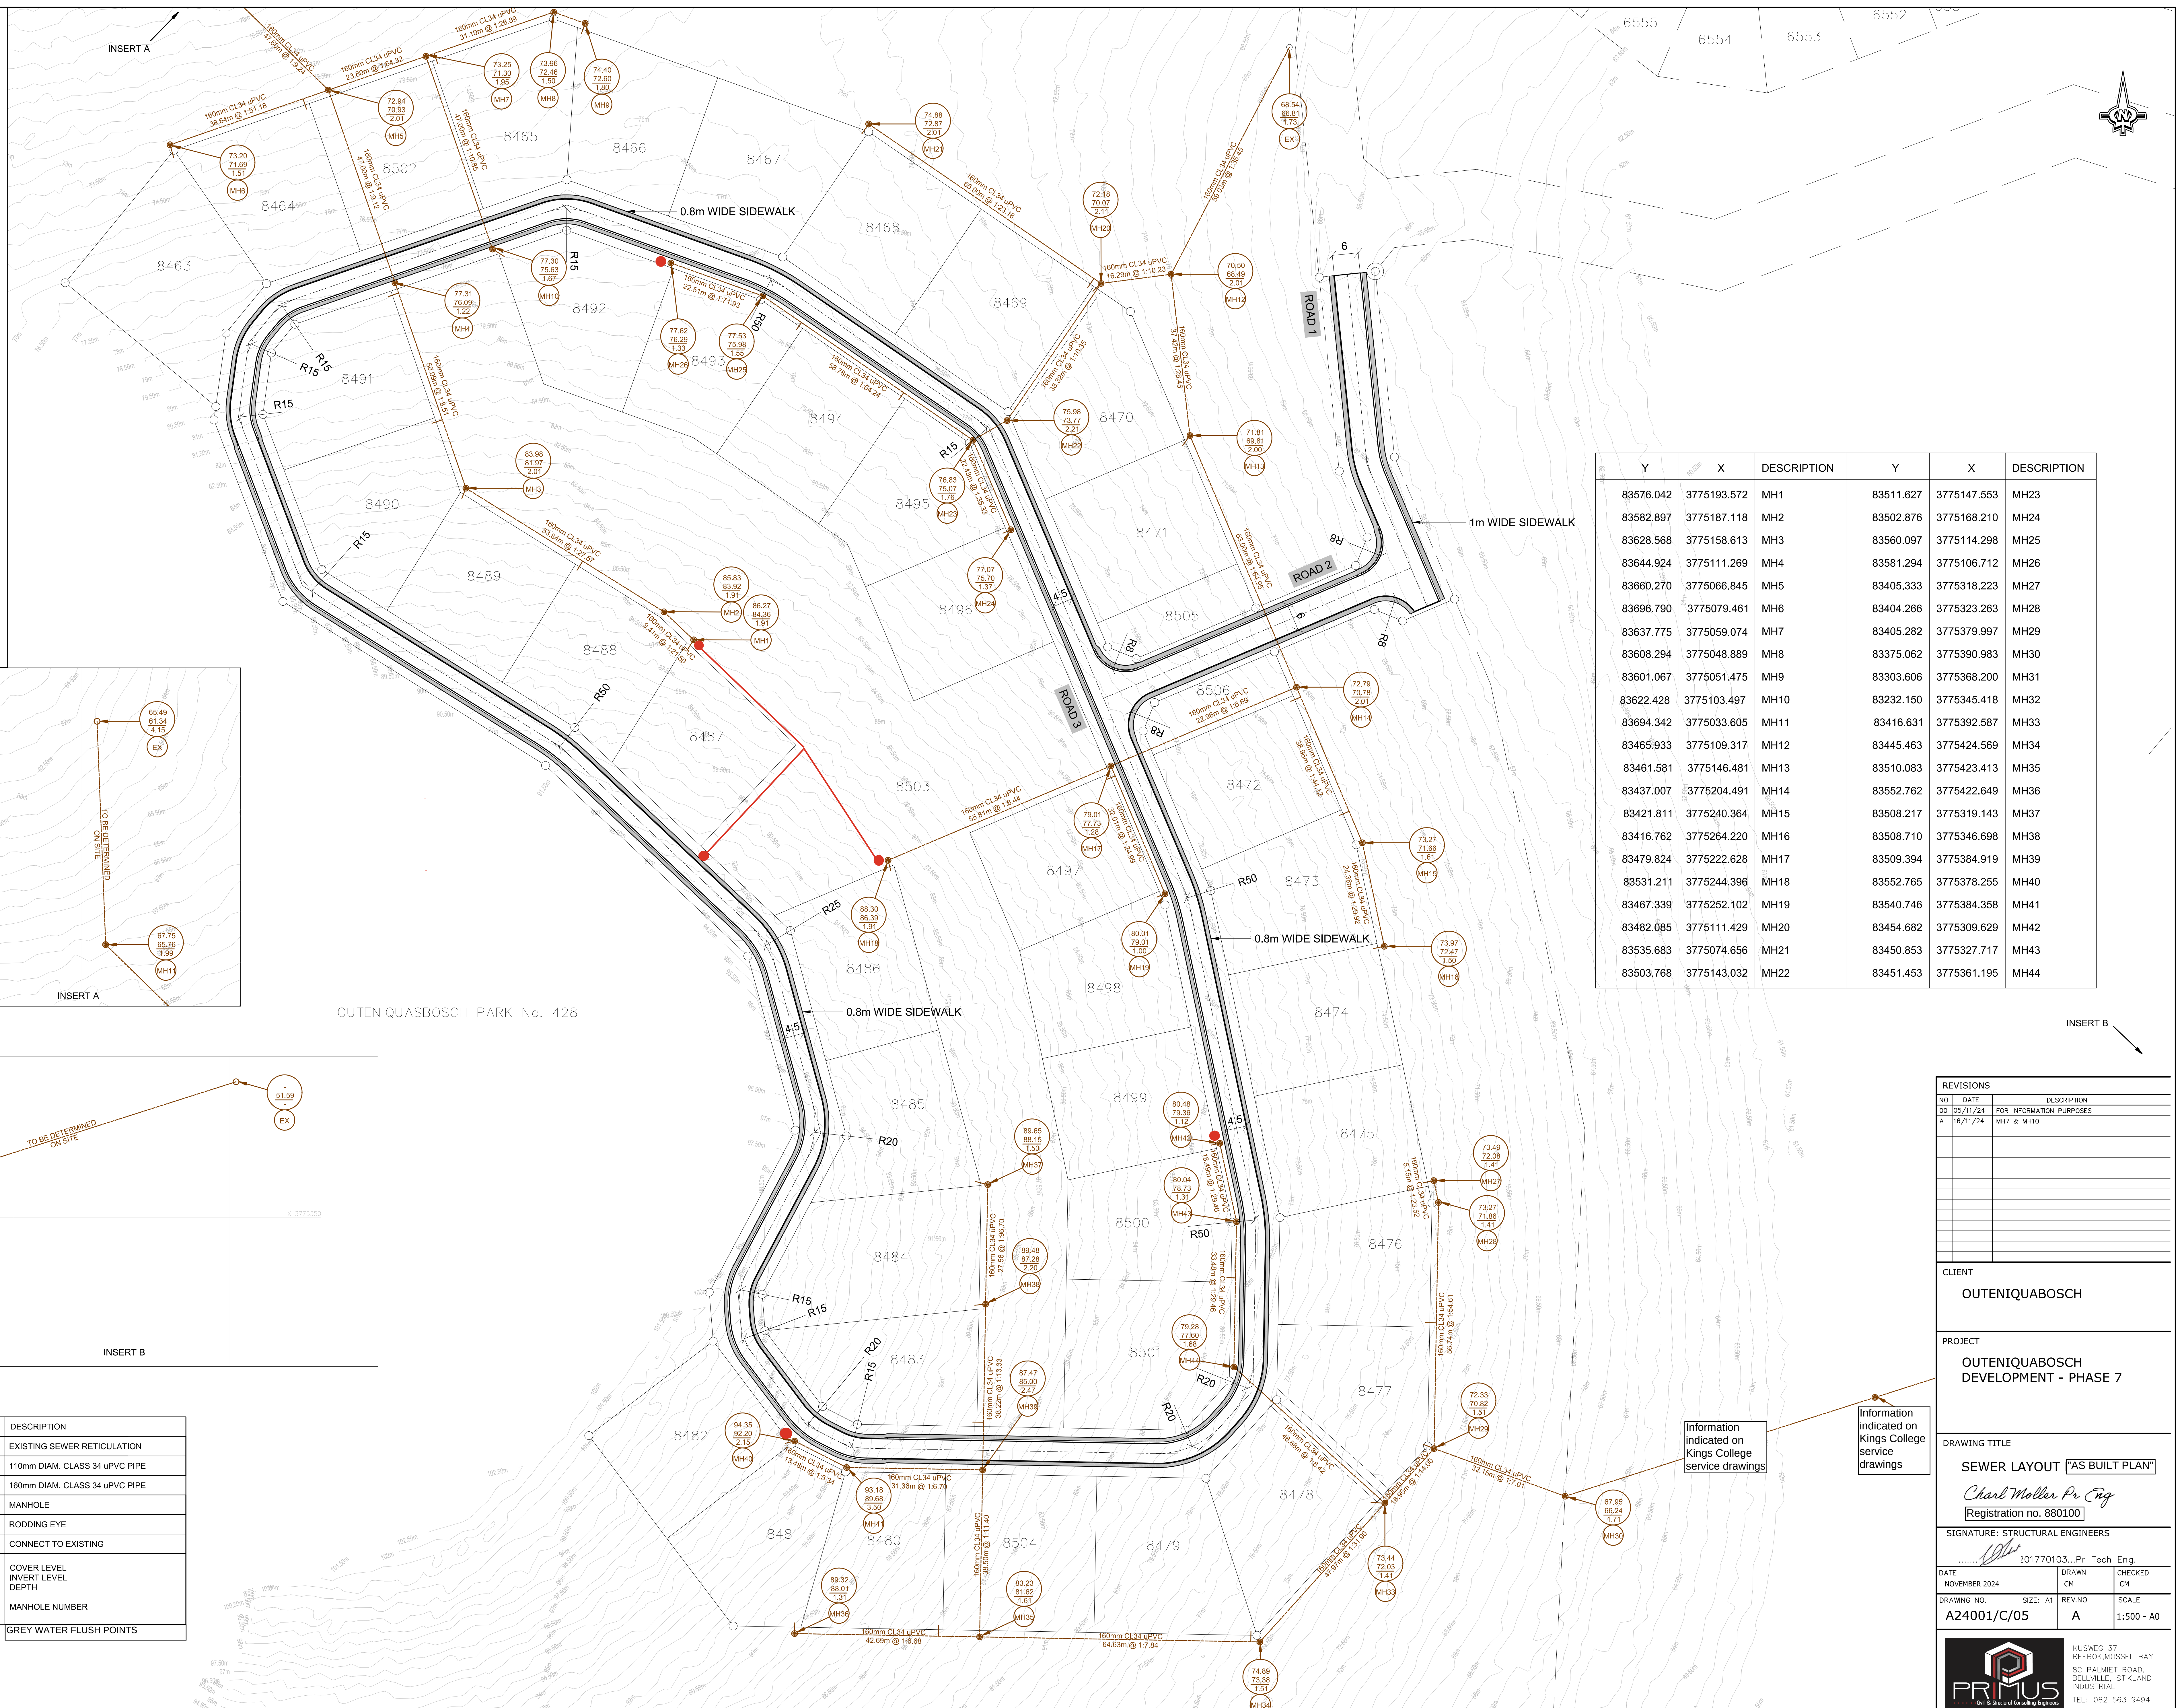

	Y	X	DESCRIPTION		Y	X	DESCRIPTION
TABLE 1 2010-2011 FISCAL YEAR	83576.042	3775193.572	MH1		83511.627	3775147.553	MH23
	83582.897	3775187.118	MH2		83502.876	3775168.210	MH24
	83628.568	3775158.613	MH3		83560.097	3775114.298	MH25
	83644.924	3775111.269	MH4		83581.294	3775106.712	MH26
	83660.270	3775066.845	MH5		83405.333	3775318.223	MH27
	83696.790	3775079.461	MH6		83404.266	3775323.263	MH28
	83637.775	3775059.074	MH7		83405.282	3775379.997	MH29
	83608.294	3775048.889	MH8		83375.062	3775390.983	MH30
	83601.067	3775051.475	MH9		83303.606	3775368.200	MH31
	83622.428	3775103.497	MH10		83232.150	3775345.418	MH32
	83694.342	3775033.605	MH11		83416.631	3775392.587	MH33
	83465.933	3775109.317	MH12		83445.463	3775424.569	MH34
	83461.581	3775146.481	MH13		83510.083	3775423.413	MH35
	83437.007	3775204.491	MH14		83552.762	3775422.649	MH36
	83421.811	3775240.364	MH15		83508.217	3775319.143	MH37
	83416.762	3775264.220	MH16		83508.710	3775346.698	MH38
	83479.824	3775222.628	MH17		83509.394	3775384.919	MH39
	83531.211	3775244.396	MH18		83552.765	3775378.255	MH40
	83467.339	3775252.102	MH19		83540.746	3775384.358	MH41
	83482.085	3775111.429	MH20		83454.682	3775309.629	MH42
83535.683	3775074.856	MH21		83450.853	3775327.717	MH43	
83503.768	3775143.032	MH22		83451.453	3775361.195	MH44	

[illegible]

CLIENT

OUTENIQUABOSCH

PROJECT

OUTENIQUABOSCH
DEVELOPMENT - PHASE 7

DRAWING TITLE

SEWER LAYOUT "AS BUILT PLAN"

Charl Moller Pr Eng
Registration no. 880100

SIGNATURE: STRUCTURAL ENGINEERS
.....  201770103...Pr Tech Eng.

DATE NOVEMBER 2024	DRAWN CM	CHECKED CM
DRAWING NO. SIZE: A1 A24001/C/05	REV.NO A	SCALE 1:500 - A0

