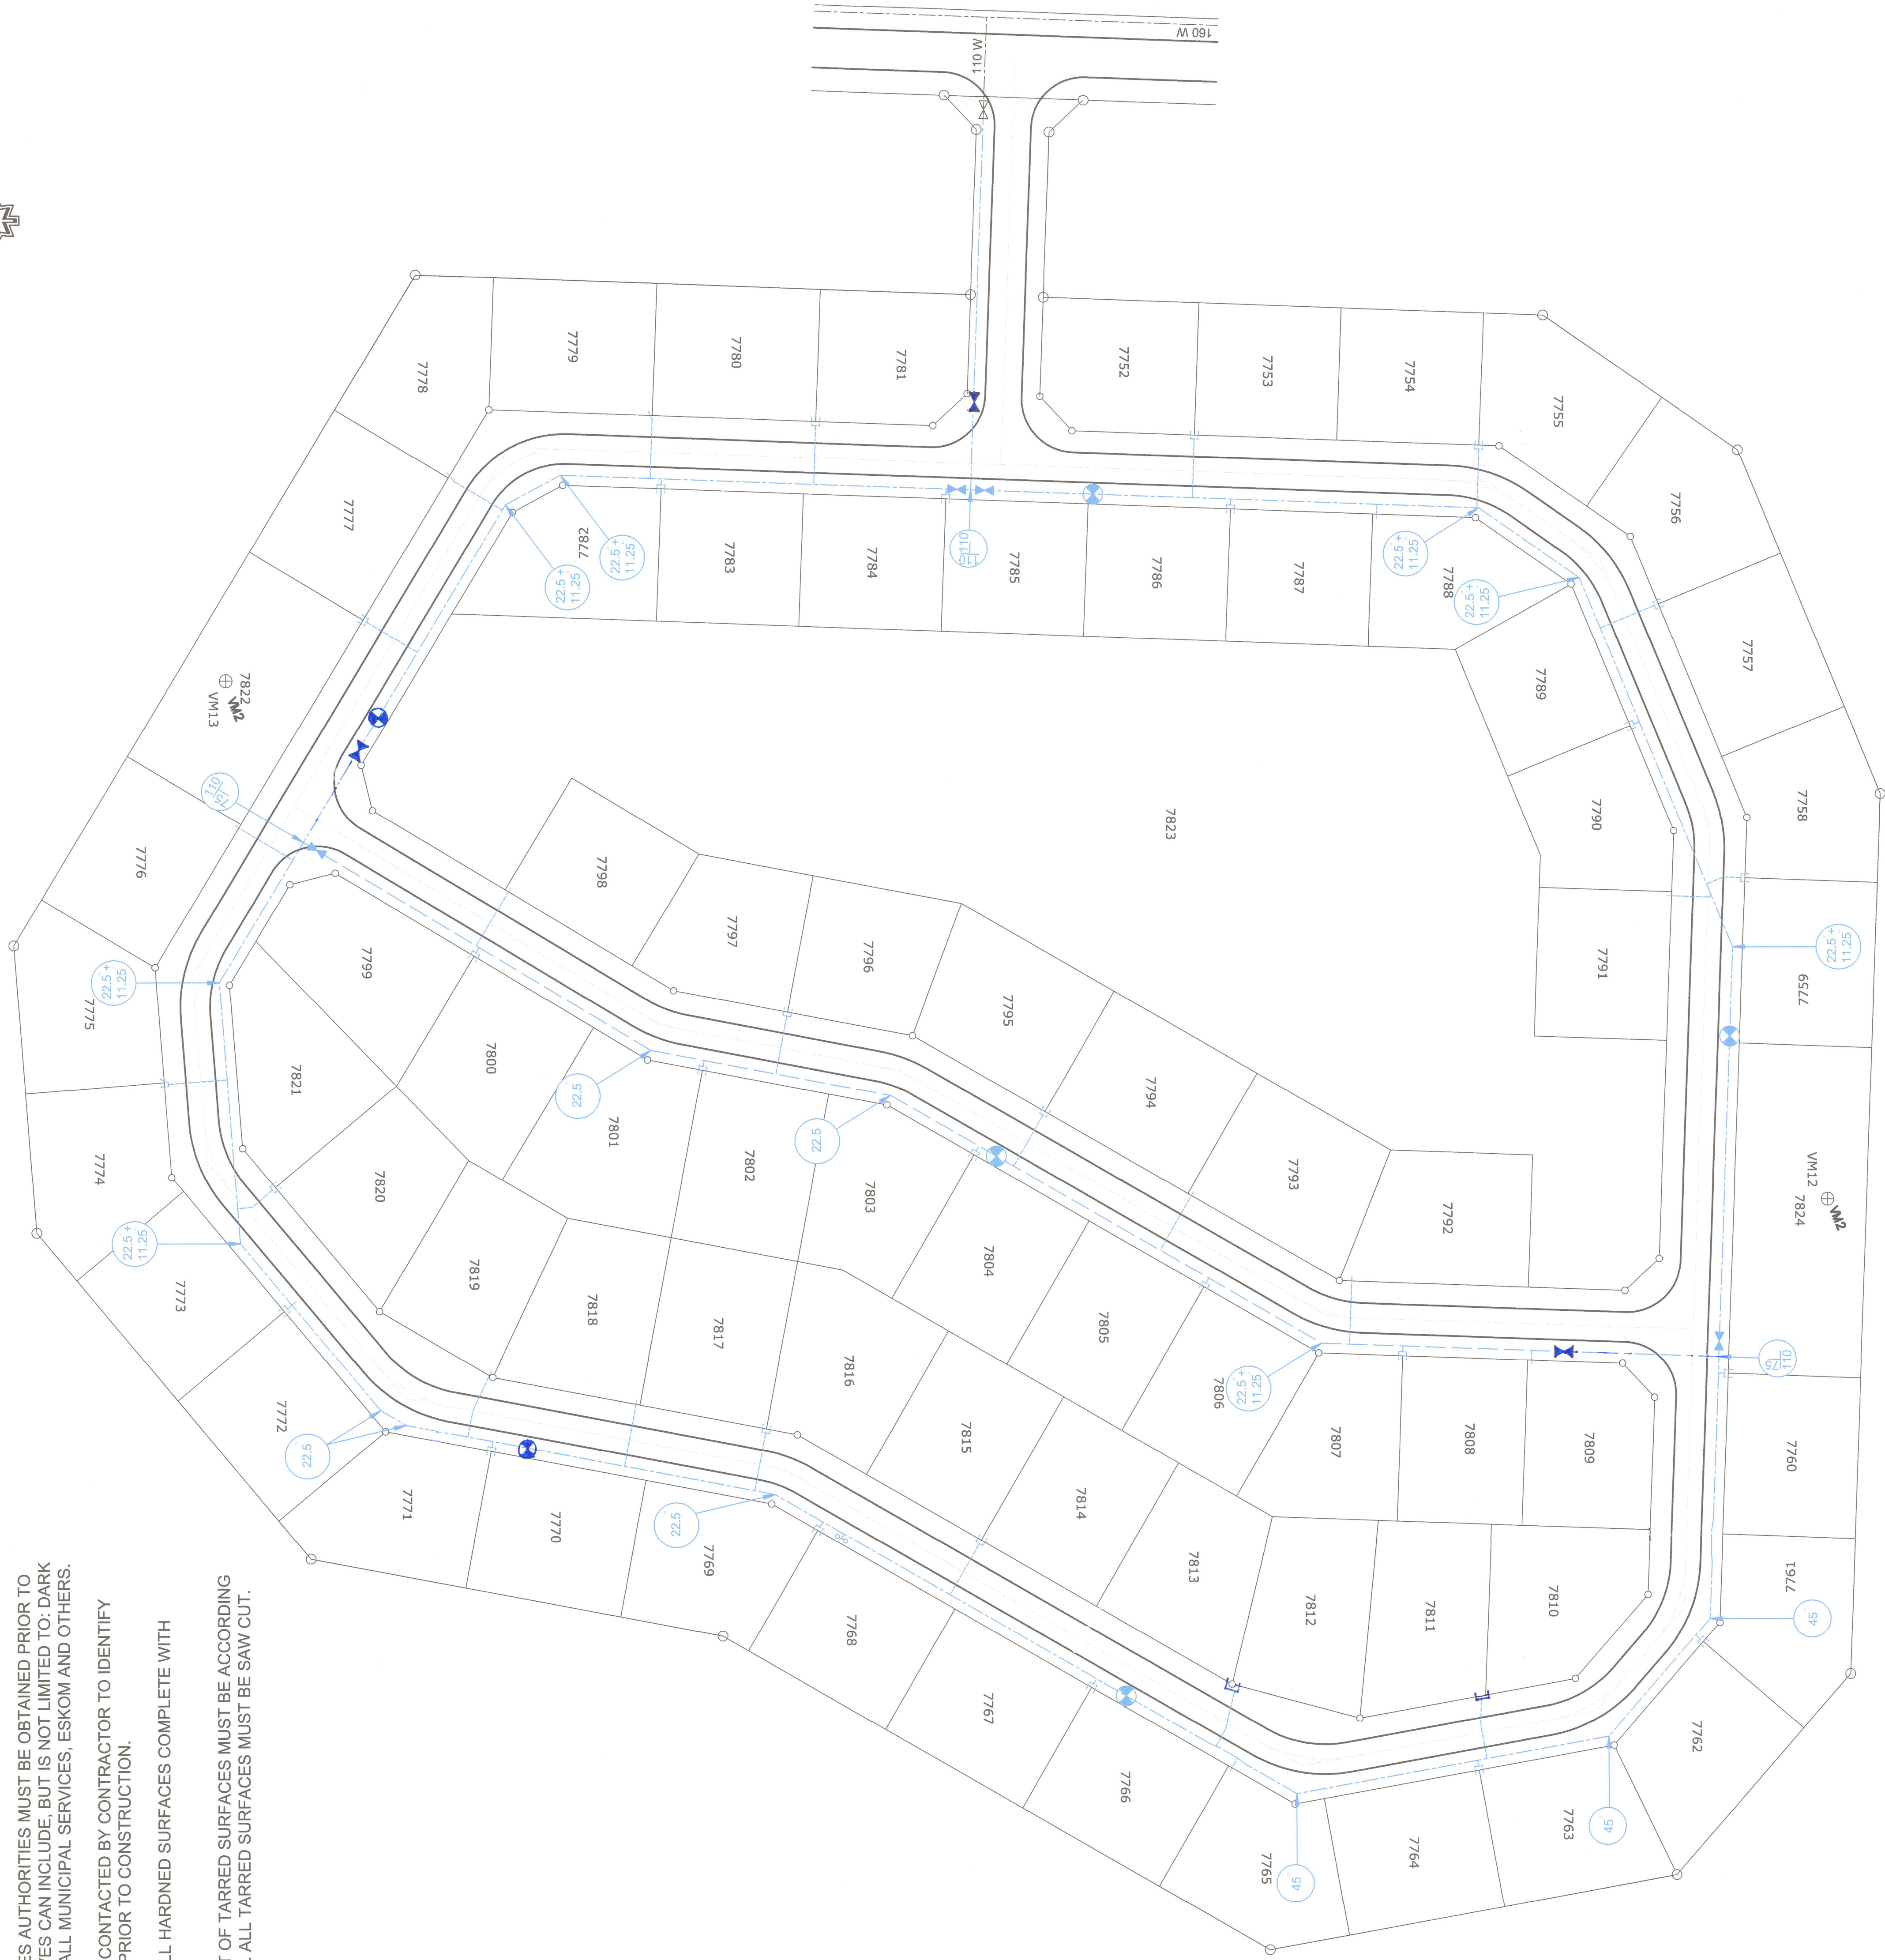


- NOTES:
1. ALL WORK MUST BE DONE STRICTLY IN ACCORDANCE WITH THE SABS 1200, THE GENERAL CONDITIONS OF CONTRACT AND THE PROJECT SPECIFICATION.
 2. THE WGS84 COORDINATE SYSTEM TO BE USED FOR ALL COORDINATES. BENCH MARKS TO BE CHECKED BY CONTRACTOR.
 3. SETTING OUT DETAIL HAS TO BE CHECKED BY THE CONTRACTOR AND THE ENGINEER MUST BE INFORMED OF ANY DISCREPANCIES BEFORE COMMENCEMENT OF CONSTRUCTION.
 4. RECORDS OF ALL CIVIL/ENGINEERING STRUCTURES, EXISTING AND NEW, TO BE SUBMITTED AT THE END OF THE CONSTRUCTION PERIOD.
 5. ANY DEVIATION FROM THE CONSTRUCTION DRAWINGS AND/OR DESIGN MUST BE SUBMITTED TO THE ENGINEER AND APPROVED IN WRITING.

LEGEND FOR WATER RETICULATION	
EXISTING	PROPOSED
	160mm DIA. uPVC CLASS 09
	110mm DIA. uPVC CLASS 09
	75mm DIA. uPVC CLASS 09
	32mm HDPE CLASS 12 (DOUBLE CONNECTION)
	32mm HDPE CLASS 12 (SINGLE CONNECTION)
	GATE VALVE
	SINGLE DOOR NON RETURN VALVE
	CONNECT TO EXISTING SYSTEM
	FIRE HYDRANT
	AIR VALVE
	ENDCAP
	T-PIECE

6. A COMPLETION CERTIFICATE WILL ONLY BE ISSUED ONCE AS-BUILT INFORMATION IS RECEIVED, INCLUSIVE OF EXISTING SERVICES INFORMATION.
7. WAYLEAVES FROM ALL SERVICES AUTHORITIES MUST BE OBTAINED PRIOR TO CONSTRUCTION, THES WAYLEAVES CAN INCLUDE, BUT IS NOT LIMITED TO: DARK FIBRE AFRICA, NEOTEL, TELKOM, ALL MUNICIPAL SERVICES, ESKOM AND OTHERS.
8. RELEVANT AUTHORITIES TO BE CONTACTED BY CONTRACTOR TO IDENTIFY ALL EXISTING SERVICES ON SITE PRIOR TO CONSTRUCTION.
9. CONTRACTOR TO REINSTATE ALL HARDENED SURFACES COMPLETE WITH ALL LAYERWORKS.
10. CUTTING AND REINSTATEMENT OF TARRED SURFACES MUST BE ACCORDING TO APPLICABLE DETAIL SUPPLIED, ALL TARRED SURFACES MUST BE SAW CUT.

[illegible]

PRIMUS
..... Civil & Structural Consulting Engineers



KUSNIG 37
REEBOK, MOSSEL BAY
8C PALMIET ROAD,
BELLVILLE, STIKLAND
INDUSTRIAL
TEL: 082 563 9494