

LEGEND FOR WATER RETICULATION


EXISTING	PROPOSED	DESCRIPTION
		160mm DIA uPVC CLASS 09
		75mm DIA uPVC CLASS 09
		32mm HDPE CLASS 12 (DOUBLE CONNECTION)
		32mm HDPE CLASS 12 (SINGLE CONNECTION)
		40mm HDPE CLASS 12
		GATE VALVE
		SINGLE DOOR NON RETURN VALVE
		CONNECT TO EXISTING SYSTEM
		FIRE HYDRANT
		AIR VALVE
		ENDCAP
		T-PIECE

NOTES:

- ALL WORK MUST BE DONE STRICTLY IN ACCORDANCE WITH THE SABS 1200, THE GENERAL CONDITIONS OF CONTRACT AND THE PROJECT SPECIFICATION.
- THE WGS84 COORDINATE SYSTEM TO BE USED FOR ALL COORDINATES. BENCH MARKS TO BE CHECKED BY CONTRACTOR.
- SETTING OUT DETAIL HAS TO BE CHECKED BY THE CONTRACTOR AND THE ENGINEER MUST BE INFORMED OF ANY DISCREPANCIES BEFORE COMMENCEMENT OF CONSTRUCTION.
- RECORDS OF ALL CIVIL ENGINEERING STRUCTURES, EXISTING AND NEW, TO BE SUBMITTED AT THE END OF THE CONSTRUCTION PERIOD.
- ANY DEVIATION FROM THE CONSTRUCTION DRAWINGS AND/ OR DESIGN MUST BE SUBMITTED TO THE ENGINEER AND APPROVED IN WRITING.

- A COMPLETION CERTIFICATE WILL ONLY BE ISSUED ONCE AS-BUILT INFORMATION IS RECEIVED, INCLUSIVE OF EXISTING SERVICES INFORMATION.
- WAYLEAVES FROM ALL SERVICES AUTHORITIES MUST BE OBTAINED PRIOR TO CONSTRUCTION. THSES WAYLEAVES CAN INCLUDE, BUT IS NOT LIMITED TO: DARK FIBRE AFRICA, NEOTEL, TELKOM, ALL MUNICIPAL SERVICES, ESKOM AND OTHERS.
- RELEVANT AUTHORITIES TO BE CONTACTED BY CONTRACTOR TO IDENTIFY ALL EXISTING SERVICES ON SITE PRIOR TO CONSTRUCTION.
- CONTRACTOR TO REINSTATE ALL HARDNED SURFACES COMPLETE WITH ALL LAYERWORKS.
- CUTTING AND REINSTATEMENT OF TARRED SURFACES MUST BE ACCORDING TO APPLICABLE DETAIL SUPPLIED. ALL TARRED SURFACES MUST BE SAW CUT.

Charl Möller
 Consulting Engineer
 ECA Reg. No.: 889100
 CEN No.: 102 489 8774
 2025.3.3
 Date

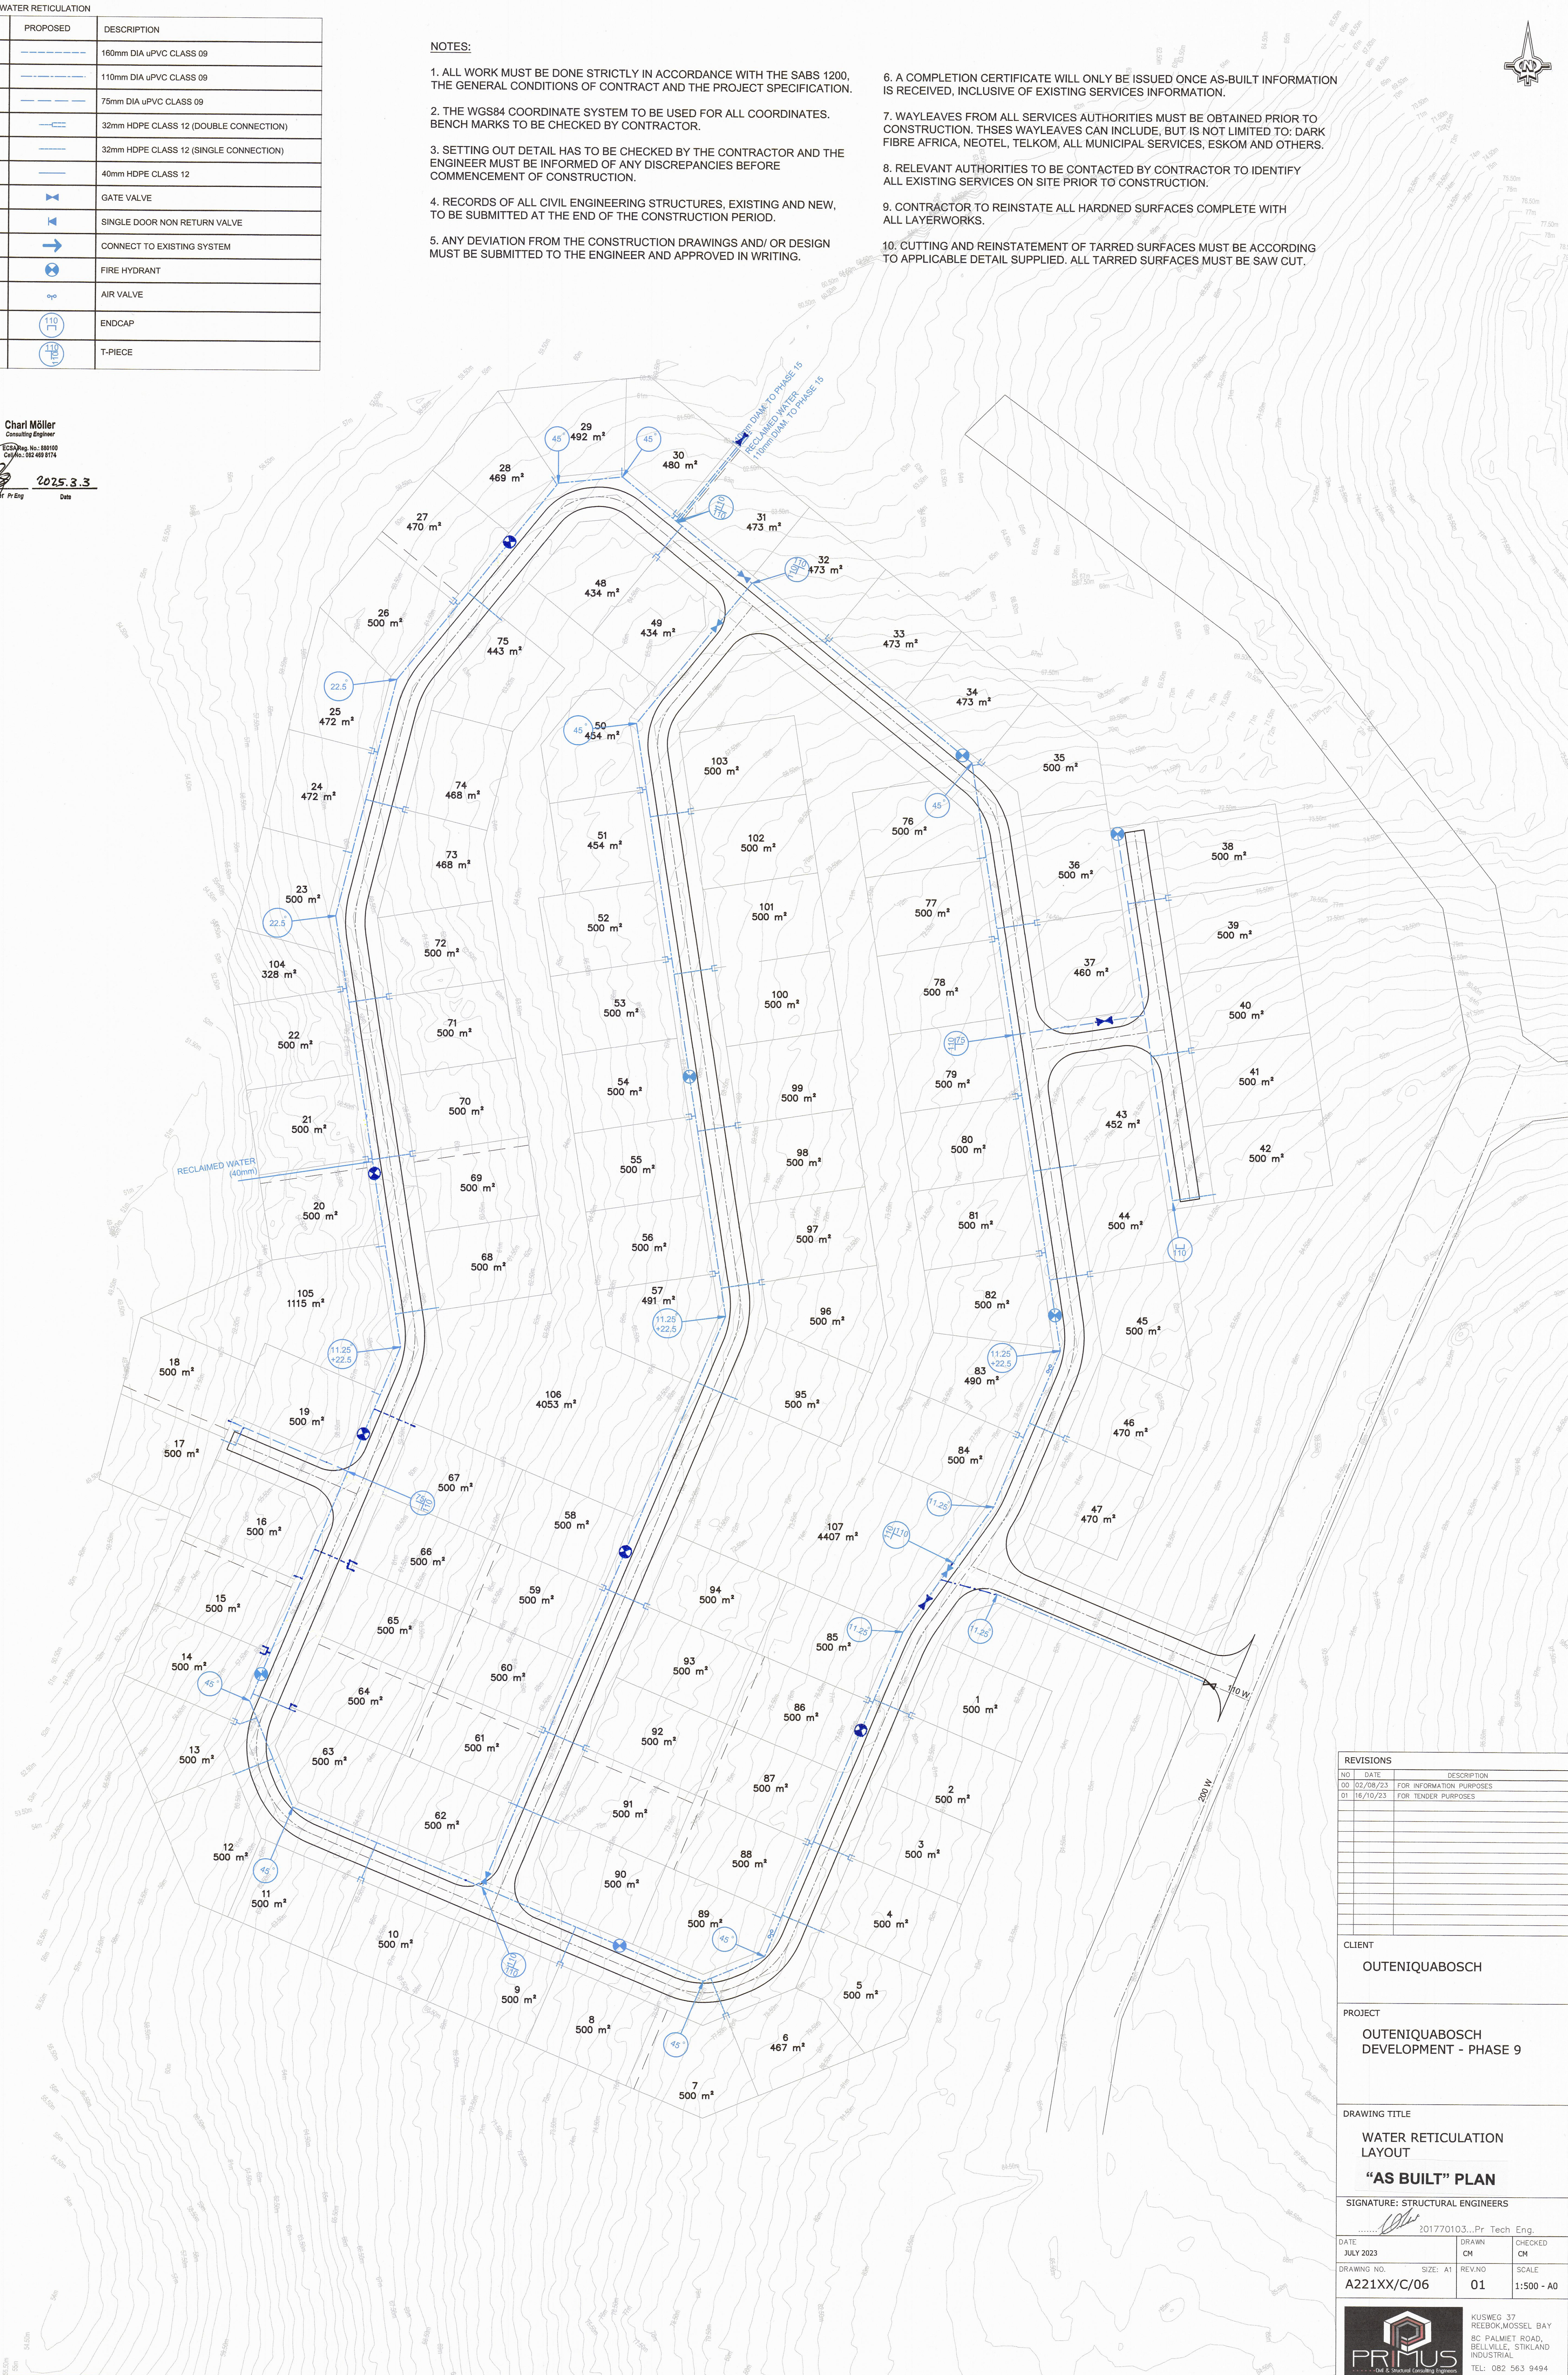

REVISIONS		
NO	DATE	DESCRIPTION
00	02/08/23	FOR INFORMATION PURPOSES
01	16/10/23	FOR TENDER PURPOSES

CLIENT
OUTENIQUABOSCH

PROJECT
**OUTENIQUABOSCH
 DEVELOPMENT - PHASE 9**

DRAWING TITLE
**WATER RETICULATION
 LAYOUT
 "AS BUILT" PLAN**

SIGNATURE: STRUCTURAL ENGINEERS
 201770103...Pr Tech Eng

DATE	REV NO	SCALE
JULY 2023	01	1:500 - A0
DRAWING NO:	SIZE: A1	REV NO
A221XX/C/06	01	1:500 - A0

PRIMUS
 - Civil & Structural Consulting Engineers -

KUSWEG 37
 REEBOK-MOSSEL BAY
 8C PALMET ROAD,
 BELLVILLE, STIKLAND
 INDUSTRIAL
 TEL: 082 563 9494