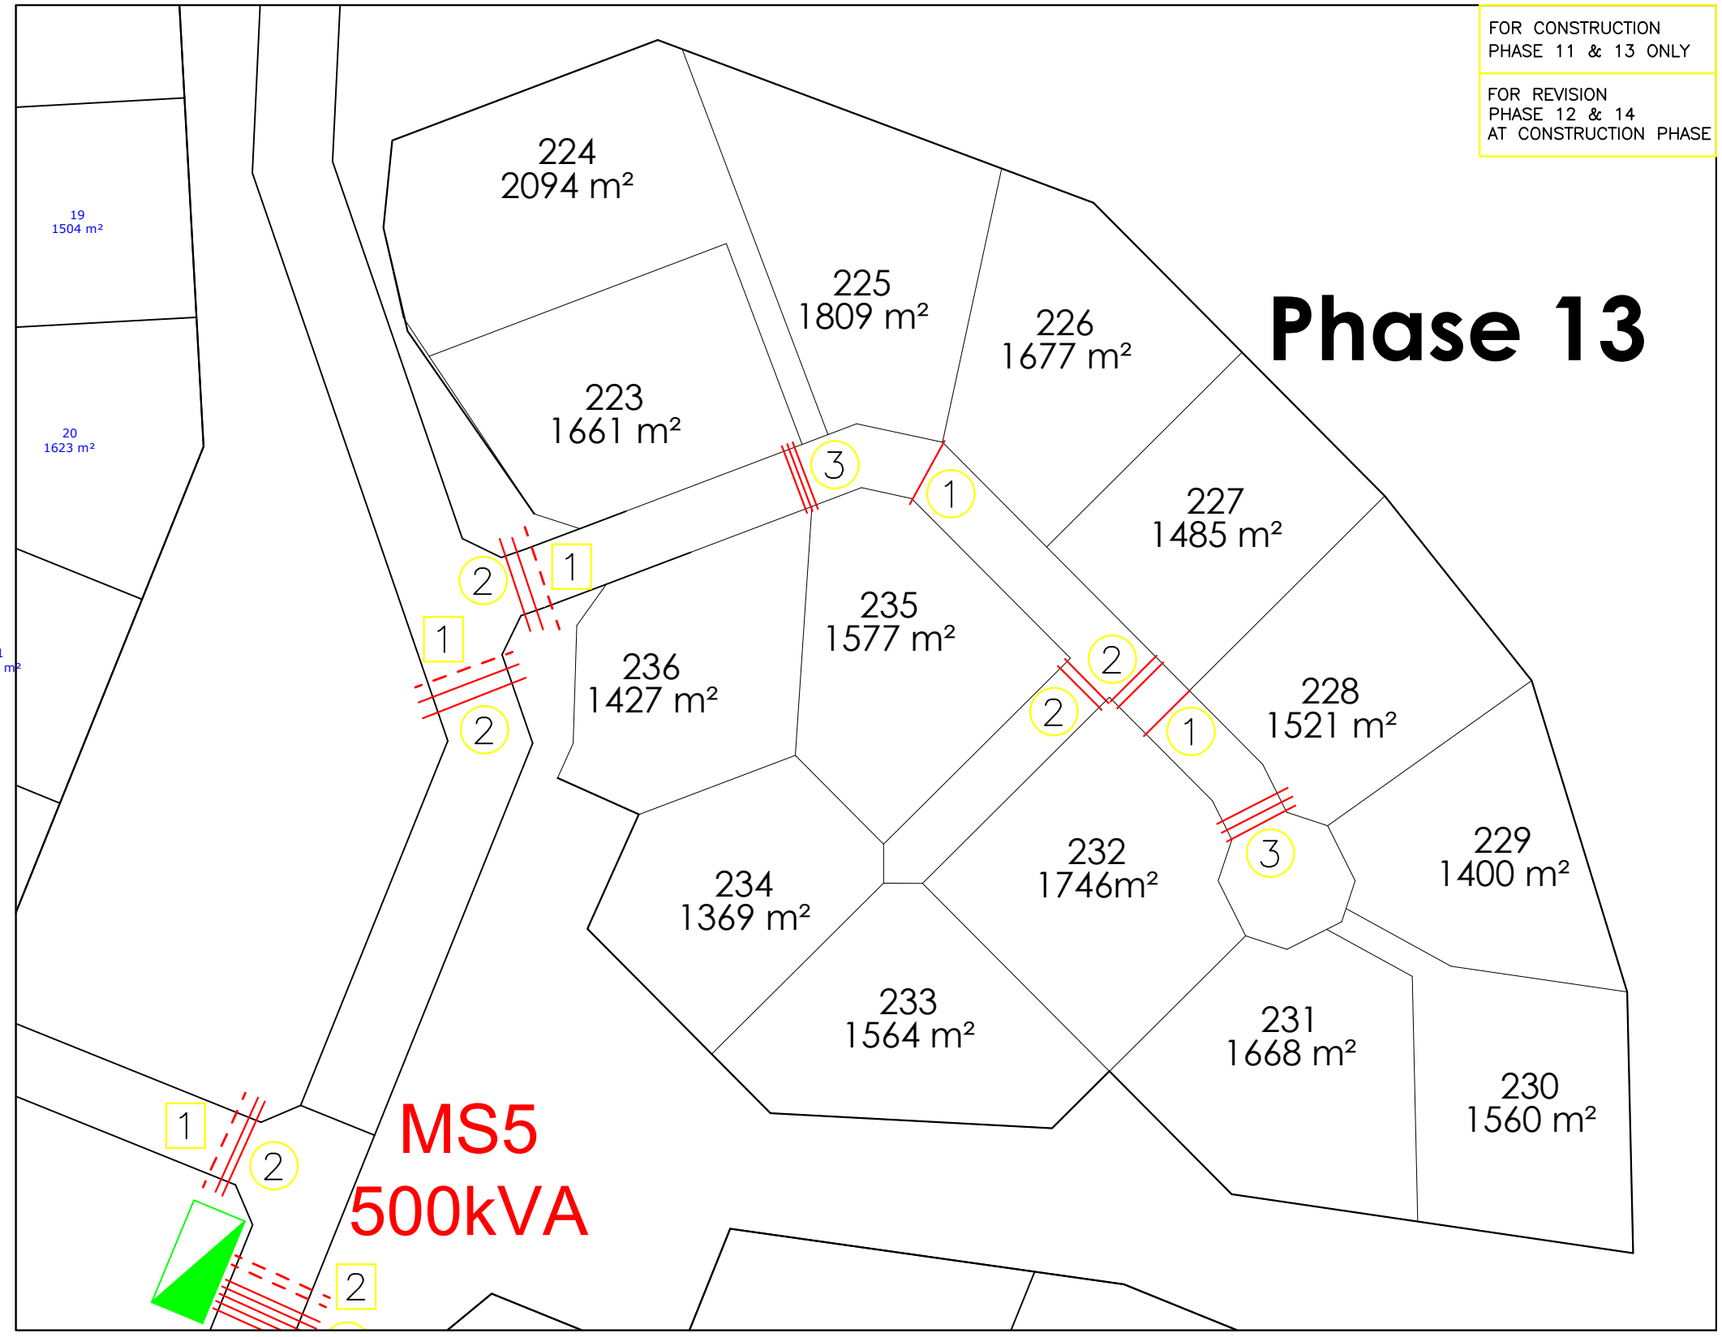

FOR CONSTRUCTION
PHASE 11 & 13 ONLY

FOR REVISION
PHASE 12 & 14
AT CONSTRUCTION PHASE

LEGEND:	
	MINI SUB
1	160mm SLEEVE
1	110mm SLEEVE

VOOR KONTRAK IN AANVANG NEEM
BEFORE CONTRACT COMMENCES

NA KONTRAK IN AANVANG GENEEM HET
AFTER CONTRACT HAS COMMENCED

Nr. No.	DATUM DATE	WYSIGINGS AMENDMENTS
0	13/05/22	ELECTRICAL + FIBRE SEPARATE FROM WATER LINES. FIBRE TO BE ADDED
1	20/05/22	ADD SLEEVE FOR FIBRE ROAD CROSSING

MOSSEL BAY
MUNICIPALITY

CESA
CVW MEGANIES EN ELEKTRIES
CVW MECHANICAL AND ELECTRICAL
RAADGEWENDE MEGANIESE & ELEKTRIESE INGENIEURS
CONSULTING MECHANICAL & ELECTRICAL ENGINEERS
MOSSELBAAI P.O. BOX 281 HARTENBOS 6520 TEL. (044)6912074
BELVILLE P.O. BOX 1889 BELVILLE 7535 TEL. (021)9454501

PROJEK / PROJECT
OUTENIQUASBOSCH

TEKENING BESKRYWING / DRAWING DESCRIPTION
SLEEVE LAYOUT
PHASE 13 – AS BUILD

TEKENING NR / DRAWING NO.
ME1589/11&13/4

REVISION
AB

SKAAL SCALE	1:1000 (A3)	NAGEGAAN CHECKED	J.B. SNYMAN
LEER Nr. FILE No.	ME	CAD NAAM CAD NAME	
DATUM DATE	08/05/2023	GETEKEN DRAWN	J.v.R.

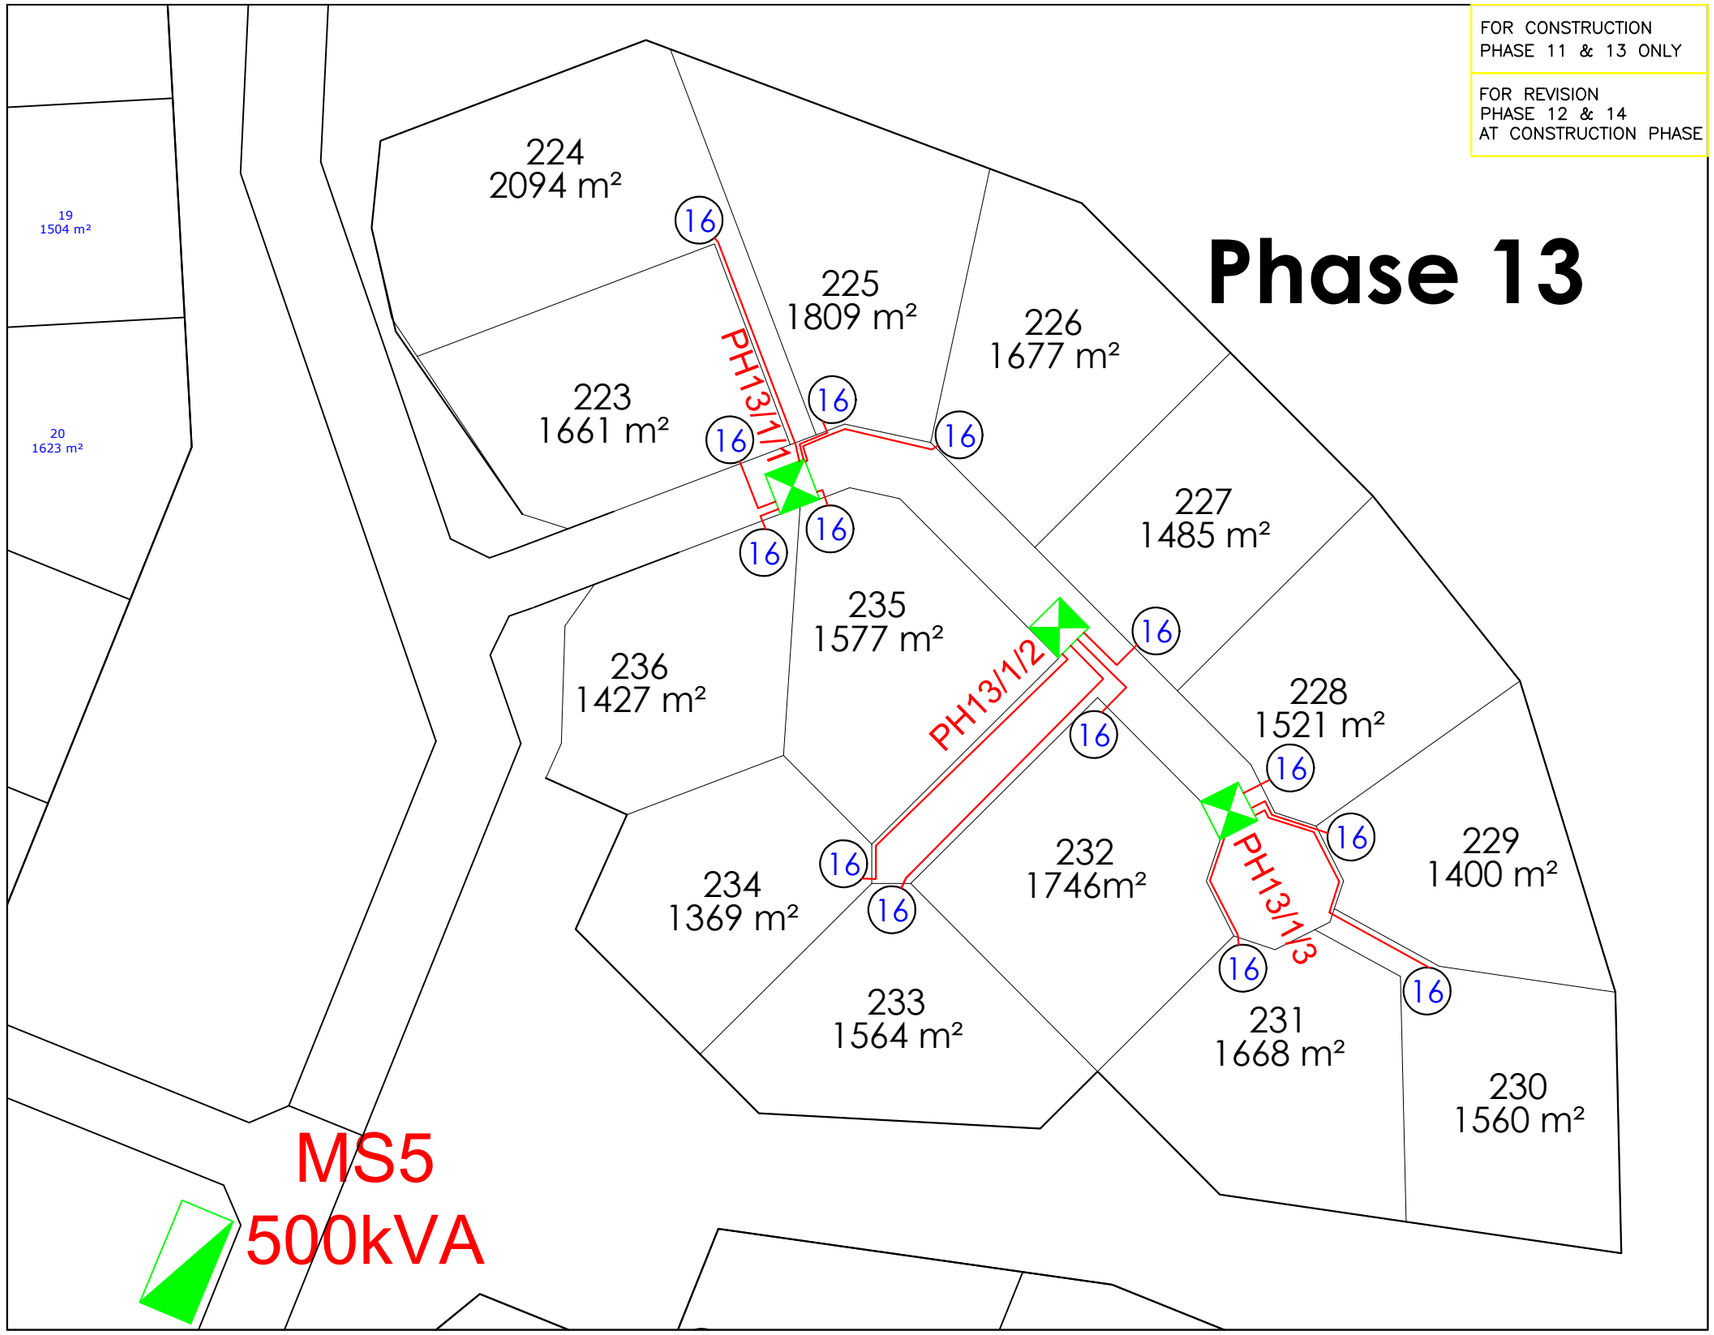

FOR CONSTRUCTION
PHASE 11 & 13 ONLY

FOR REVISION
PHASE 12 & 14
AT CONSTRUCTION PHASE

LEGEND:	
	MINI SUB
	NEW R.M.U
	KIOSK
	4Core Cu PVC SWA UNDERGROUND CABLE
95	4Core Cu PVC SWA UNDERGROUND CABLE 95mm2

MOSSEL BAY
MUNICIPALITY

CESA
CVW MEGANIES EN ELEKTRIES
CVW MECHANICAL AND ELECTRICAL
RAADGEWENDE MEGANIESE & ELEKTRIESE INGENIEURS
CONSULTING MECHANICAL & ELECTRICAL ENGINEERS
MOSSELBAAI P.O. BOX 281 HARTENBOS 6520 TEL. (044)6912074
BELVILLE P.O. BOX 1889 BELVILLE 7535 TEL. (021)9454501

PROJEK / PROJECT
OUTENIQUASBOSCH

TEKENING BESKRYWING / DRAWING DESCRIPTION
SERVICE CONNECTIONS LAYOUT
PHASE 13 – AS BUILD

TEKENING NR / DRAWING NO.	REVISIE / REVISION
ME1589/11&13/3	AB

SKAAL / SCALE	1:1000 (A3)	NAGESIEN / CHECKED	J.B. SNYMAN
LEER Nr / FILE No.	ME	CAD NAAM / CAD NAME	
DATUM / DATE	01/02/2022	GETEKEN / DRAWN	J.v.R.

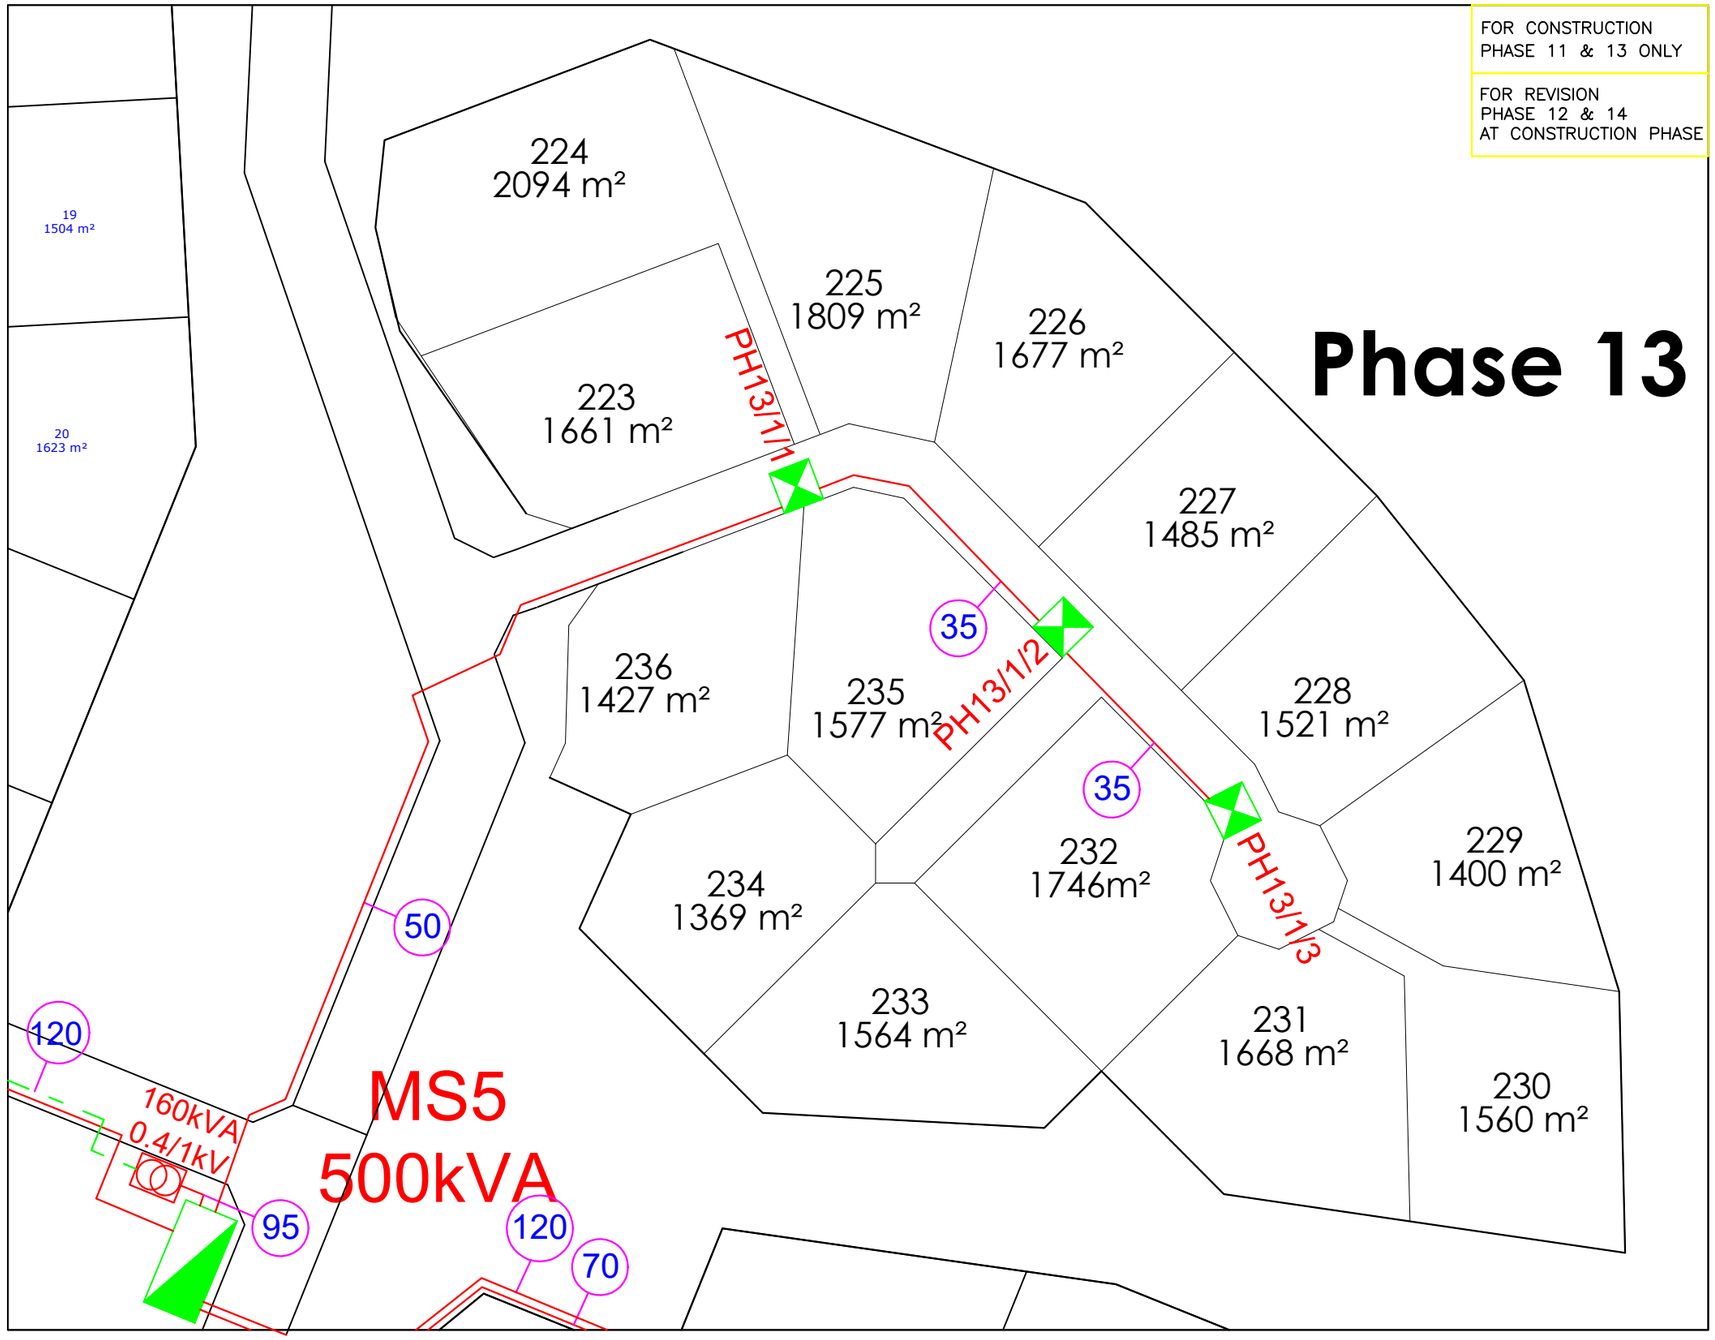

Phase 13

FOR CONSTRUCTION
PHASE 11 & 13 ONLY

FOR REVISION
PHASE 12 & 14
AT CONSTRUCTION PHASE

LEGEND:	
	MINI SUB
	NEW R.M.U
	KIOSK
	4Core Cu PVC SWA UNDERGROUND CABLE
95	4Core Cu PVC SWA UNDERGROUND CABLE 95mm2
	4Core 1kV Cu PVC SWA UNDERGROUND CABLE

MOSSEL BAY
MUNICIPALITY

CESA
CVW MEGANIES EN ELEKTRIES
CVW MECHANICAL AND ELECTRICAL
RAADGEWENDE MEGANIESE & ELEKTRIESE INGENIEURS
CONSULTING MECHANICAL & ELECTRICAL ENGINEERS
MOSSELBAAI P.O. BOX 281 HARTENBOS 6520 TEL. (044)6912074
BELVILLE P.O. BOX 1889 BELVILLE 7535 TEL. (021)9454501

PROJEK / PROJECT
OUTENIQUASBOSCH

TEKENING BESKRYWING / DRAWING DESCRIPTION
LOW VOLTAGE LAYOUT
PHASE 13 – AS BUILD

TEKENING NR. / DRAWING NO.	REVISION
ME1589/11&13/2	AB

SKAAL SCALE	1:1000 (A3)	NAGESAAN CHECKED	J.B. SNYMAN
LÊER NR. FILE NO.	ME	CAD NAAM CAD NAME	
DATUM DATE	01/02/2022	GETEKEN DRAWN	J.v.R.

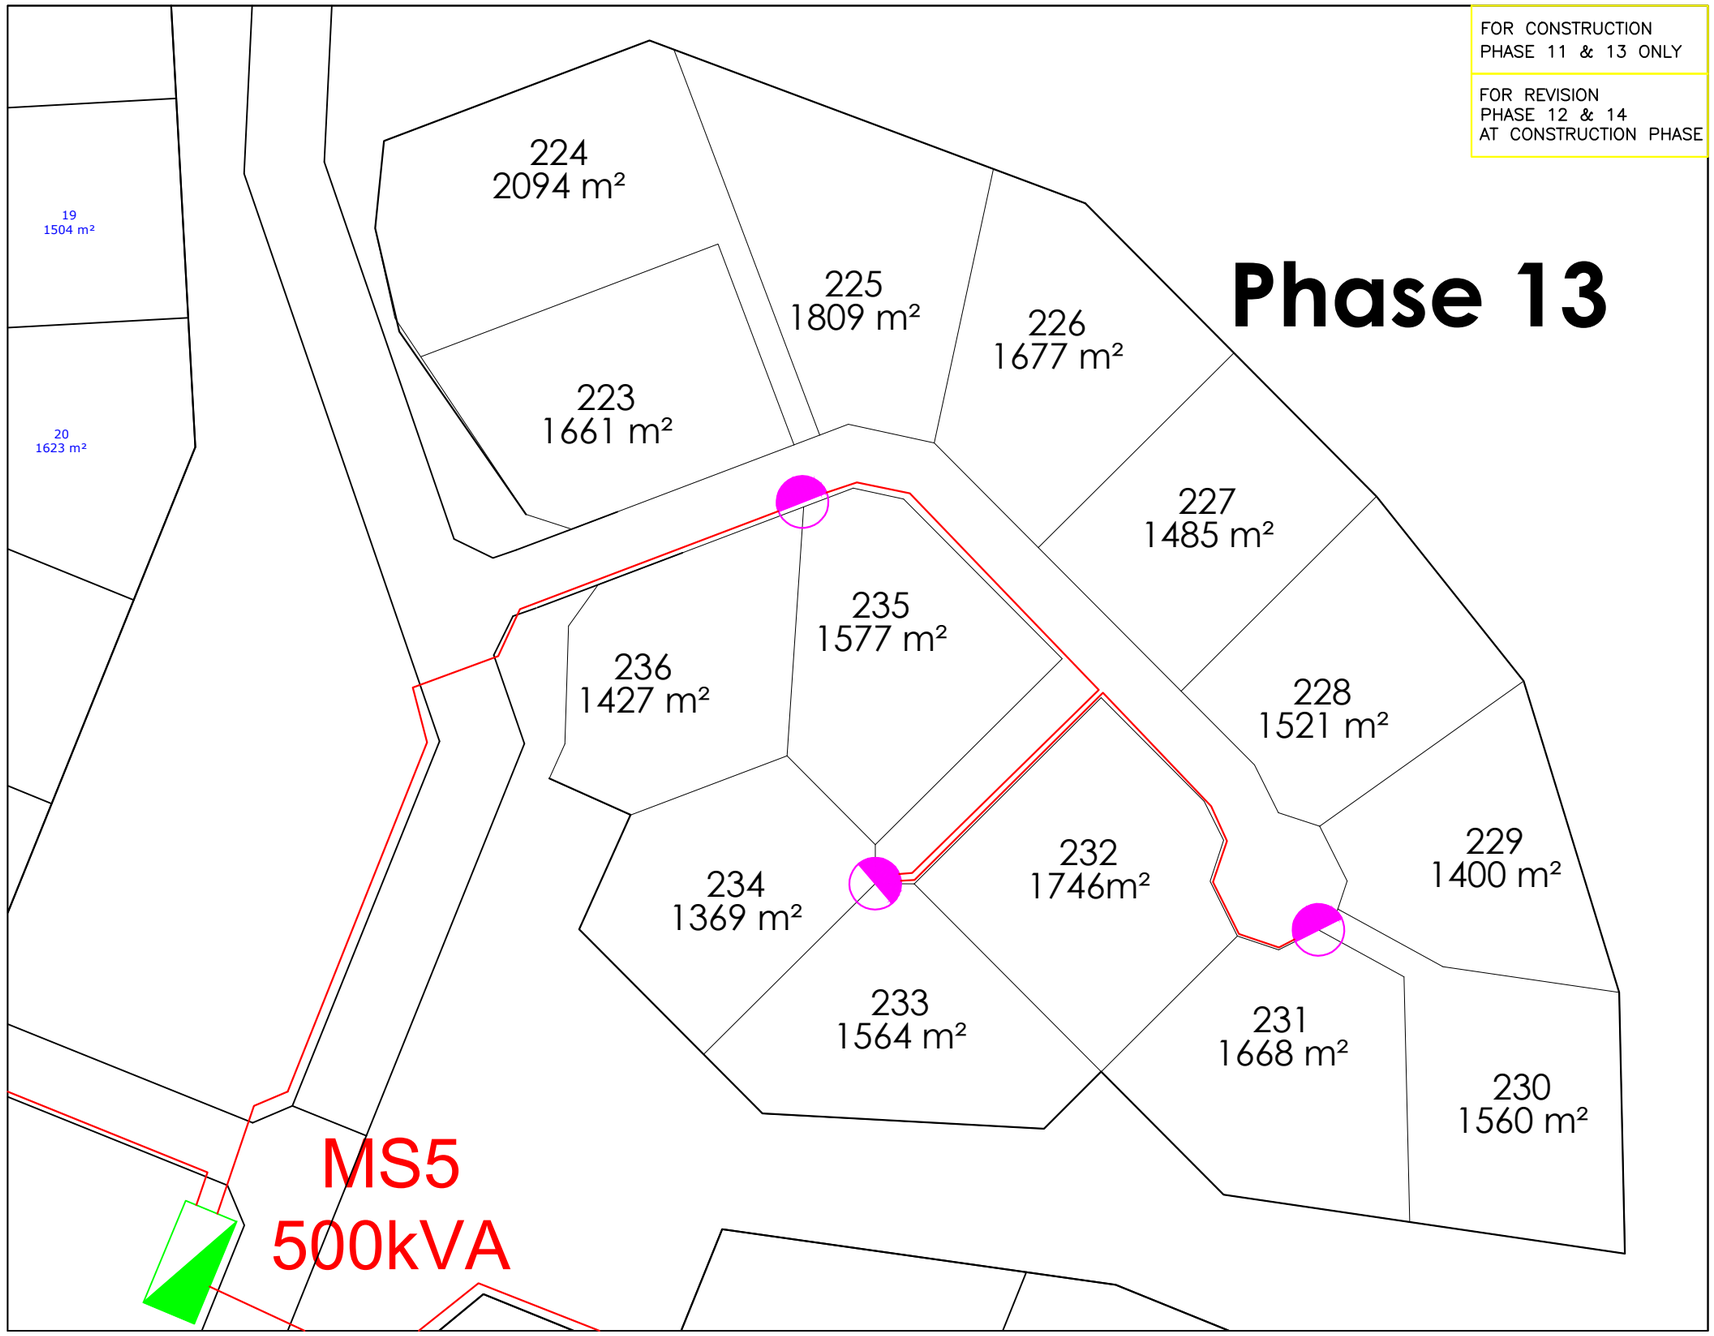

FOR CONSTRUCTION
PHASE 11 & 13 ONLY

FOR REVISION
PHASE 12 & 14
AT CONSTRUCTION PHASE

LEGEND:

	MINI SUB
	STREET LIGHT
	2Core Cu PVC SWA UNDERGROUND CABLE
4	CABLE SIZE MARKER 4mm2

MOSSEL BAY
MUNICIPALITY

CESA
CVW MEGANIES EN ELEKTRIES
CVW MECHANICAL AND ELECTRICAL
RAADGEWENDE MEGANIESE & ELEKTRIESE INGENIEURS
CONSULTING MECHANICAL & ELECTRICAL ENGINEERS
MOSSELBAAI P.O. BOX 281 HARTENBOS 6520 TEL. (044)6912074
BELVILLE P.O. BOX 1889 BELVILLE 7535 TEL. (021)9454501

PROJEK / PROJECT
OUTENIQUASBOSCH

TEKENING BESKRYWING / DRAWING DESCRIPTION
STREET LIGHTING LAYOUT
PHASE 13 – AS BUILD

TEKENING NR / DRAWING NO.	REVISIE / REVISION
ME1589/11&13/5	AB

SKAAL SCALE	1:1000 (A3)	NAGESIEN CHECKED	J.B. SNYMAN
LEER NR FILE No.	ME	CAD NAAM CAD NAME	
DATUM DATE	01/02/2022	GETEKEN DRAWN	J.v.R.